




ITE	DESCRIPTION
1	Welded Cover w/ Handhole
2	Cooling Radiators
3	Copper Ground Bus
4	Copper Ground Bus
5	Current Limiting Backup Fuses (Internal)
6	Drain Valve with Sampler and Cover
7	Gauge Cabinet
8	Ground Pad .50-13 Tap
9	Ground Strap
10	High Security Cabinet w/ Pentahead Door Bolts
11	35kV 600 Amp Deadbreak HV Bushing
12	Internal Cartridge Fusing
13	LV Bushing Support
14	Lifting Lug
15	Liquid Temperature Gauge
16	1.2kV LV Bushing w/12 Hole Spade Supported
17	Magnetic Oil Level Gauge w/ Alarm Contacts
18	NEMA 4 Control Box
19	Nameplate
20	One Inch Upper Press. Conn. and Fill Plug
21	Two Position Loadbreak Switch
22	Parking Stand
23	Pressure Relief Valve
24	Pressure Vacuum Gauge
25	Schrader Valve
26	Seismic Anchor Provisions
27	Tank Base w/ Jacking and Rolling Facilities
28	5-Position Tap Changer
29	X0 Bushing

3PH Padmount Transformer 60Hz
3500.0 kVA ONAN 65 AWR Mineral Oil
HV 34500D 150 kV BIL
LV 690Y/398 30 kV BIL
6.67 %IZ
ANSI 70 Gray Topcoat
Mild Steel Construction
Cabinet Mounting Provisions for Type D Kirk Key
CSA Ground Straps in Cabinet
CSA Decals & Stencils
Nitrogen Blanket
3" IR Windows in HV & LV Cabinet doors

S.O. Number : 210971135
P.O. Number : 1966
Customer Name: RES CANADA CONSTRUCTION (ONTARIO)
Project Name : NORTH KENT WIND FARM


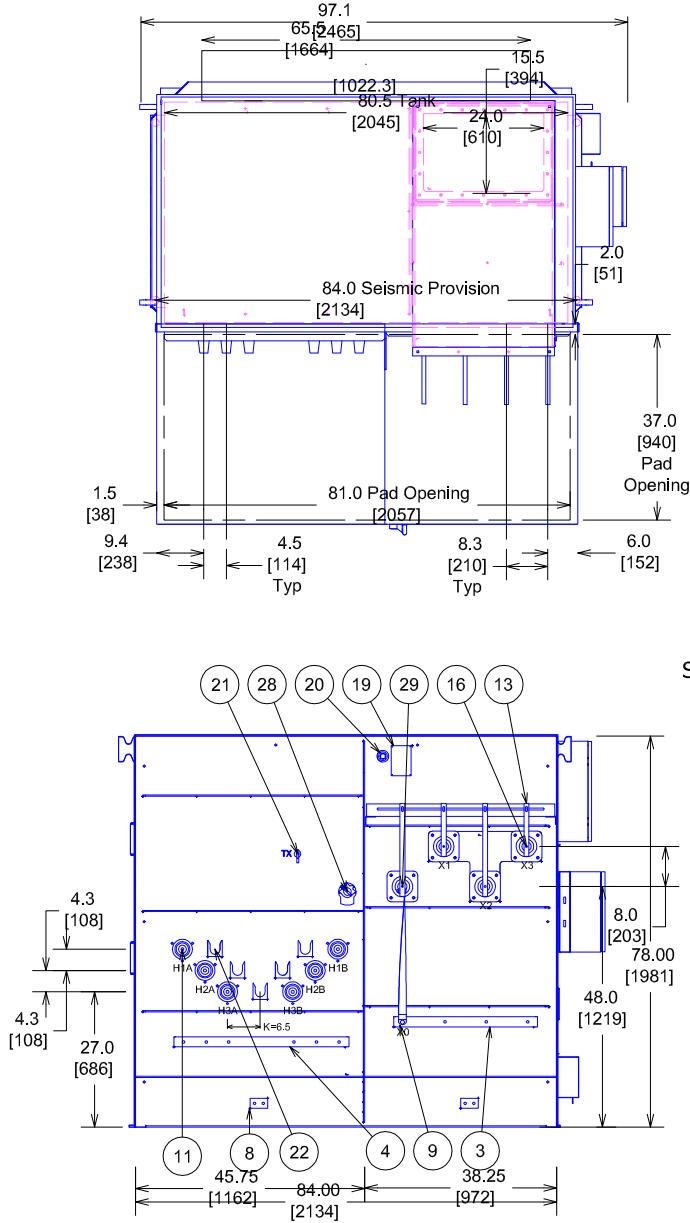


Seismic Provision Detail

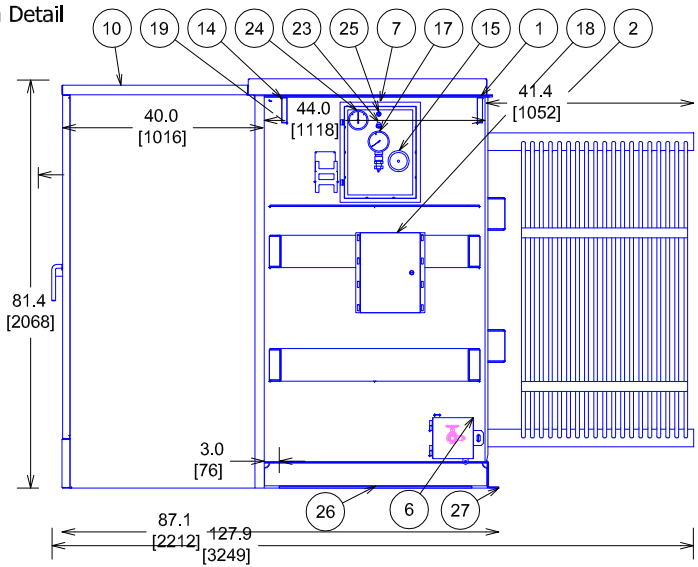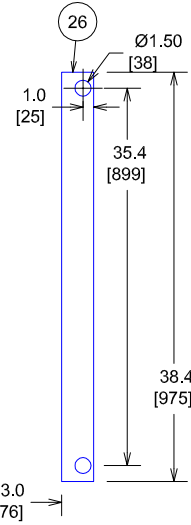

MATERIAL:		EATON Powering Business Worldwide	
ALL DIMENSIONS ARE IN INCHES [MM]		TITLE: Distribution Transformer Outline Drawing	
THE INFORMATION ON THIS DOCUMENT WAS CREATED BY EATON. IT WAS DISCLOSED IN CONFIDENCE AND IS ONLY TO BE USED FOR THE PURPOSE IN WHICH IT WAS SUPPLIED.		DESC: COOPER POWER SERIES THREE-PHASE PAD-MOUNTED COMPARTMENTAL TYPE	
DWG: PTP	DATE: 3/23/2017	REF: P3D V03R08M01	SHEET #: 1 OF 1
THIS DRAWING HAS BEEN GENERATED FROM A 3D MODEL.		SCALE:	REV: 03
00025A67KDEA			

REVISIONS
REV01 EVJ 08/MAY/17 Changes Per CHC
REV02 EVJ 30/MAY/17 Changes Per CHC
REV03 EVJ 14/JUN/17 Remove GS Bushing

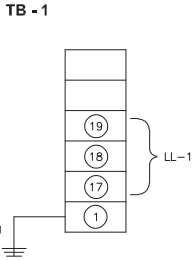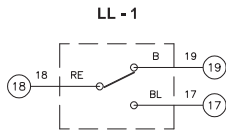

GAGE SWITCH SETTINGS						
DEVICE	LT 55°C AWR	LT 65°C, 55/65 AWR	LT 75°C, 55/75, 65/75 AWR	WTI 55°C AWR	WTI 65°C, 55/65 AWR	WTI 75°C, 55/75, 65/75 AWR
S-1 (FANS)	60°C	70°C	80°C	70°C	80°C	90°C
S-2 (ALARM)	80°C	90°C	100°C	110°C	120°C	130°C
S-3 (TRIP)	105°C FIXED	105°C FIXED	120°C FIXED	120°C FIXED	130°C FIXED	140°C FIXED

LL-1 LIQUID LEVEL GAGE (71Q)
S-1 ACTIVATES LOW LEVEL ALARM CIRCUIT
TB-(1-1) TERMINAL BLOCK, 600V, 35A

- USE COOPER CONDUCTORS ONLY, #22 - 10 AWG
- TB-(1-1) SCREW TIGHTENING TORQUE 18-20.0 IN.LB

WH - WHITE
GR - GREEN
BL - BLACK
B - BLUE
OR - ORANGE
RE - RED
BR - BROWN
YE - YELLOW

GAGE SWITCH RATINGS (AMPS)				
DEVICE	120/240VAC	48VDC	125VDC	250VDC
LT/LL/ PRD/RRR	15	1.3	.50	.25
SPC	10	2.0	.50	.25
PS/VS	5	1.0	.40	.20
WTI	15	1.3	.50	.25
TPG	1	--	--	--
LCP	3	--	--	--
U	5	2.0	2.0	N/A

NOTE: AC LOADS = INDUCTIVE P.F. 75%
DC LOADS = NON-INDUCTIVE

LEGEND

- ===== INDICATES PREWIRED DEVICE
- INDICATES REMOTE DEVICE
- 26 INDICATES WIRE HEAT SHRINK NUMBER LABEL
- 26 OR 26 INDICATES TERMINAL BLOCK CONNECTION
- 26 INDICATES INTRINSICALLY SAFE TERM BLOCK CONN
- 12 INDICATES RELAY TERM AND #

- INDICATES SPLICE
- INDICATES NORMALLY CLOSED CONTACT (NC)
- INDICATES NORMALLY OPEN CONTACT (NO)
- } INDICATES CUSTOMER CONNECTION
- POLARITY MARK
- * INDICATES CT SHORTING PINS - TO BE REMOVED WHEN LOAD IS CONNECTED TO CT
- * WIRE COLORS APPLICABLE ONLY WHEN USING CORD CONNECTORS TO SWITCHES

MATERIAL:		EATON Powering Business Worldwide			
ALL DIMENSIONS ARE IN INCHES [MM]		TITLE: SCHEMATIC LL			
THE INFORMATION ON THIS DOCUMENT WAS CREATED BY EATON. IT WAS DISCLOSED IN CONFIDENCE AND IS ONLY TO BE USED FOR THE PURPOSE IN WHICH IT WAS SUPPLIED.		DESC: COOPER POWER SERIES 3PH PAD			
DWG: PTP	DATE: 05/12/15	REF:	SHEET #: 1 of 1	SCALE: 1=1	REV: 00
4257572C0030					

Current in Amperes: x 1 at 34.5 kV.

